



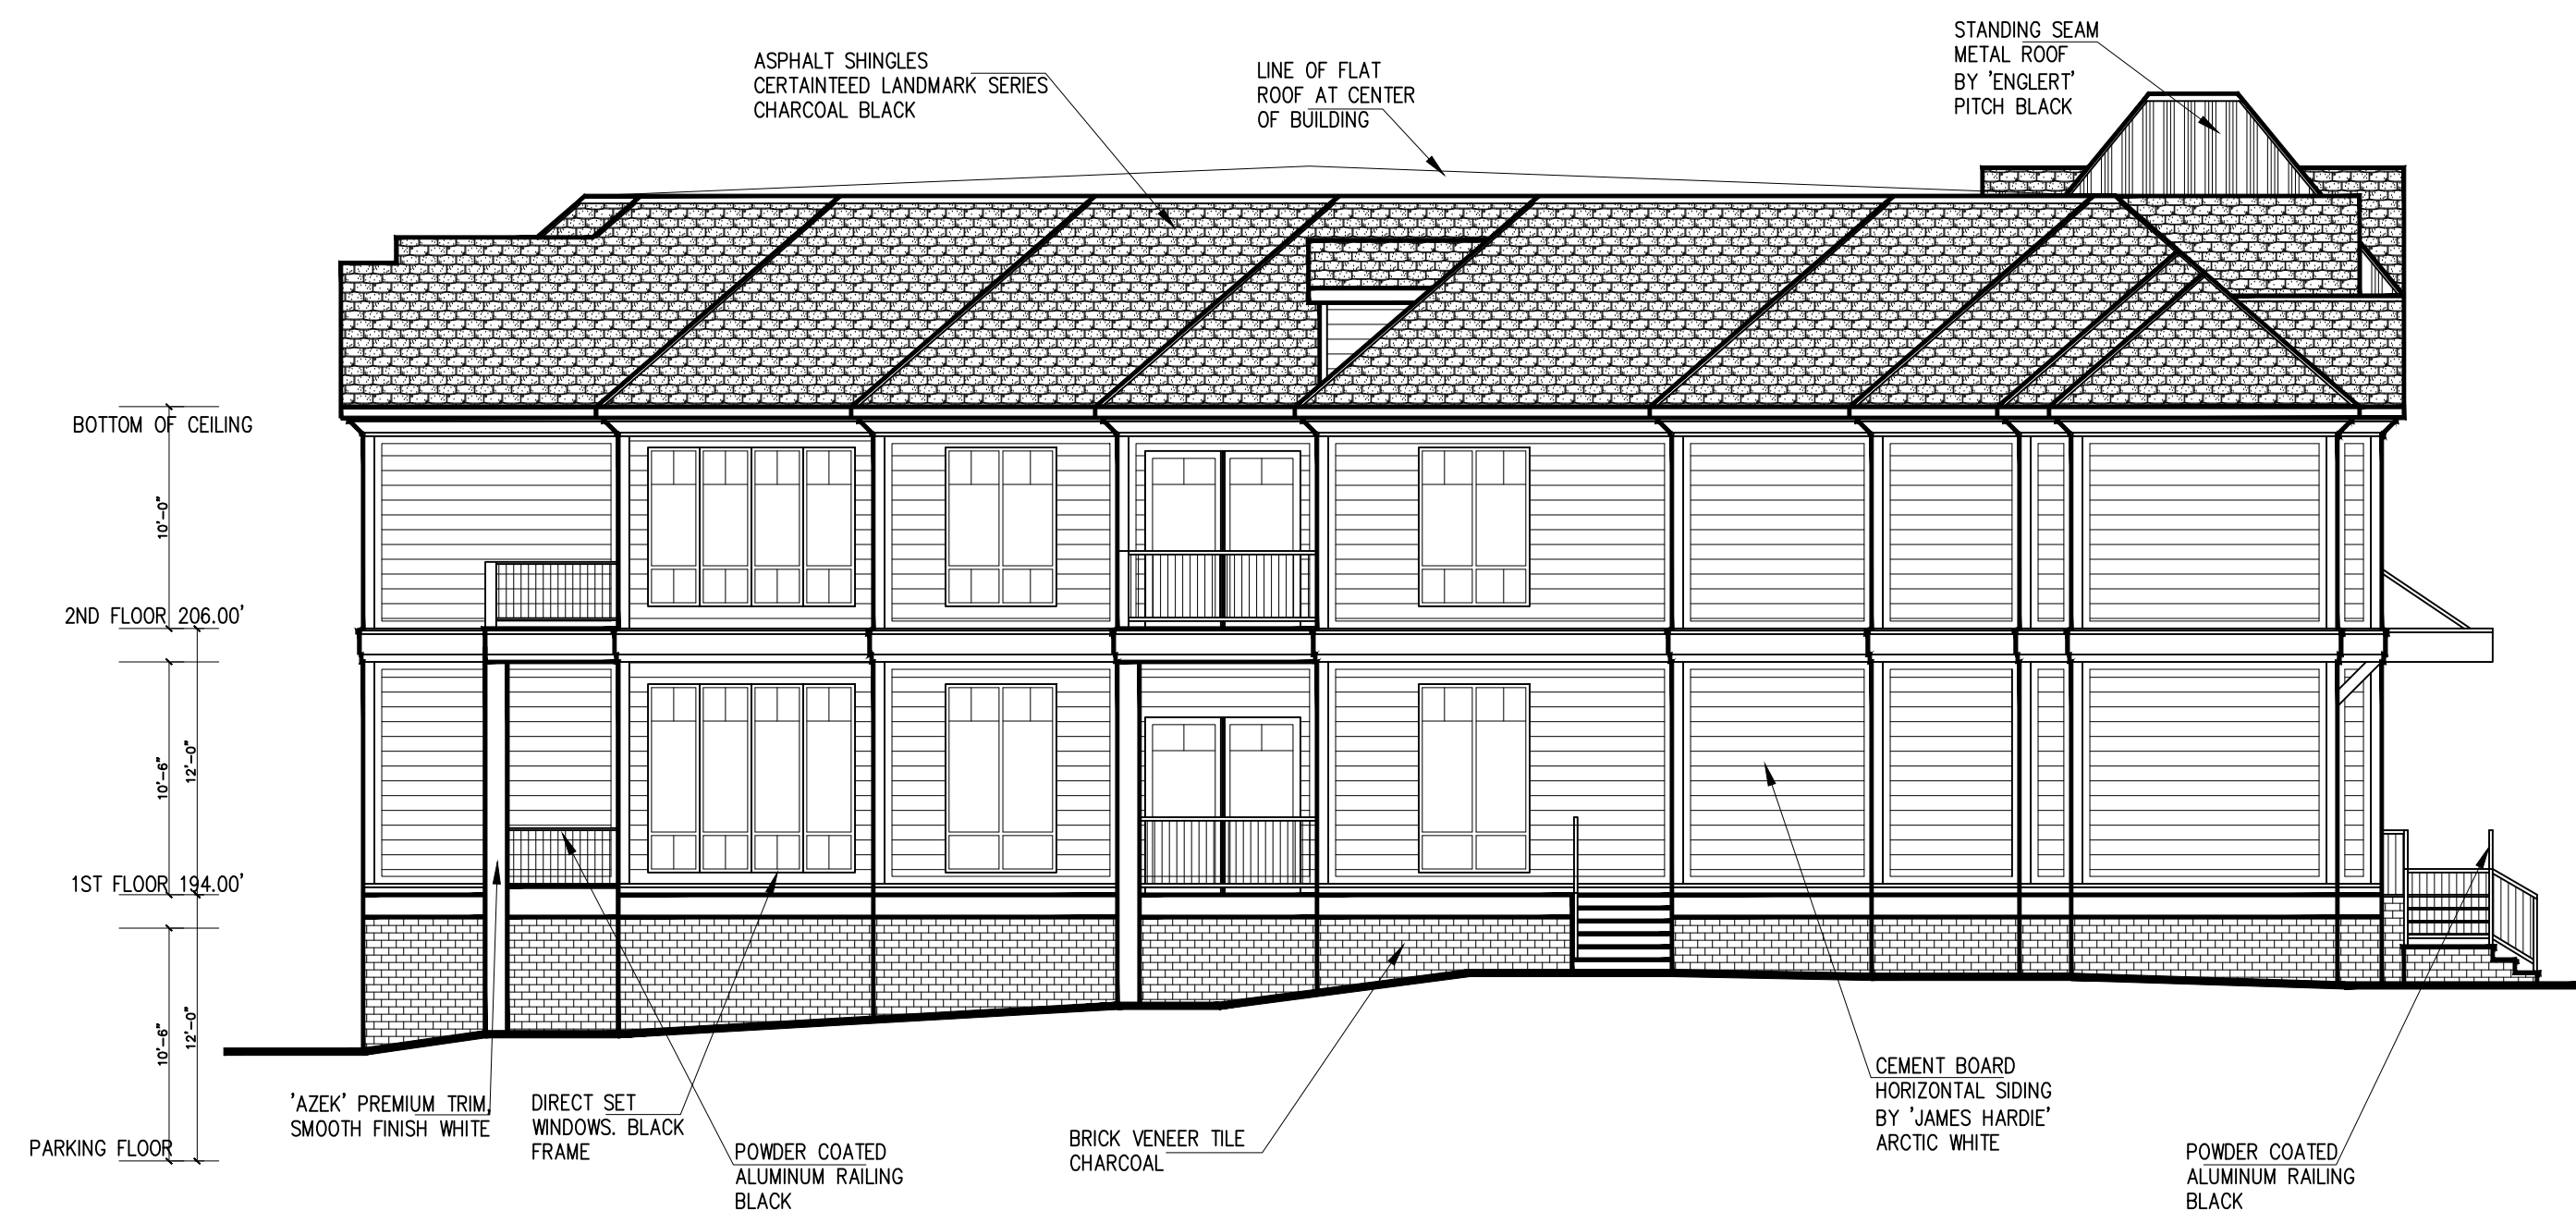


WEST ELEVATION

SCALE: 1/8" = 1'-0"

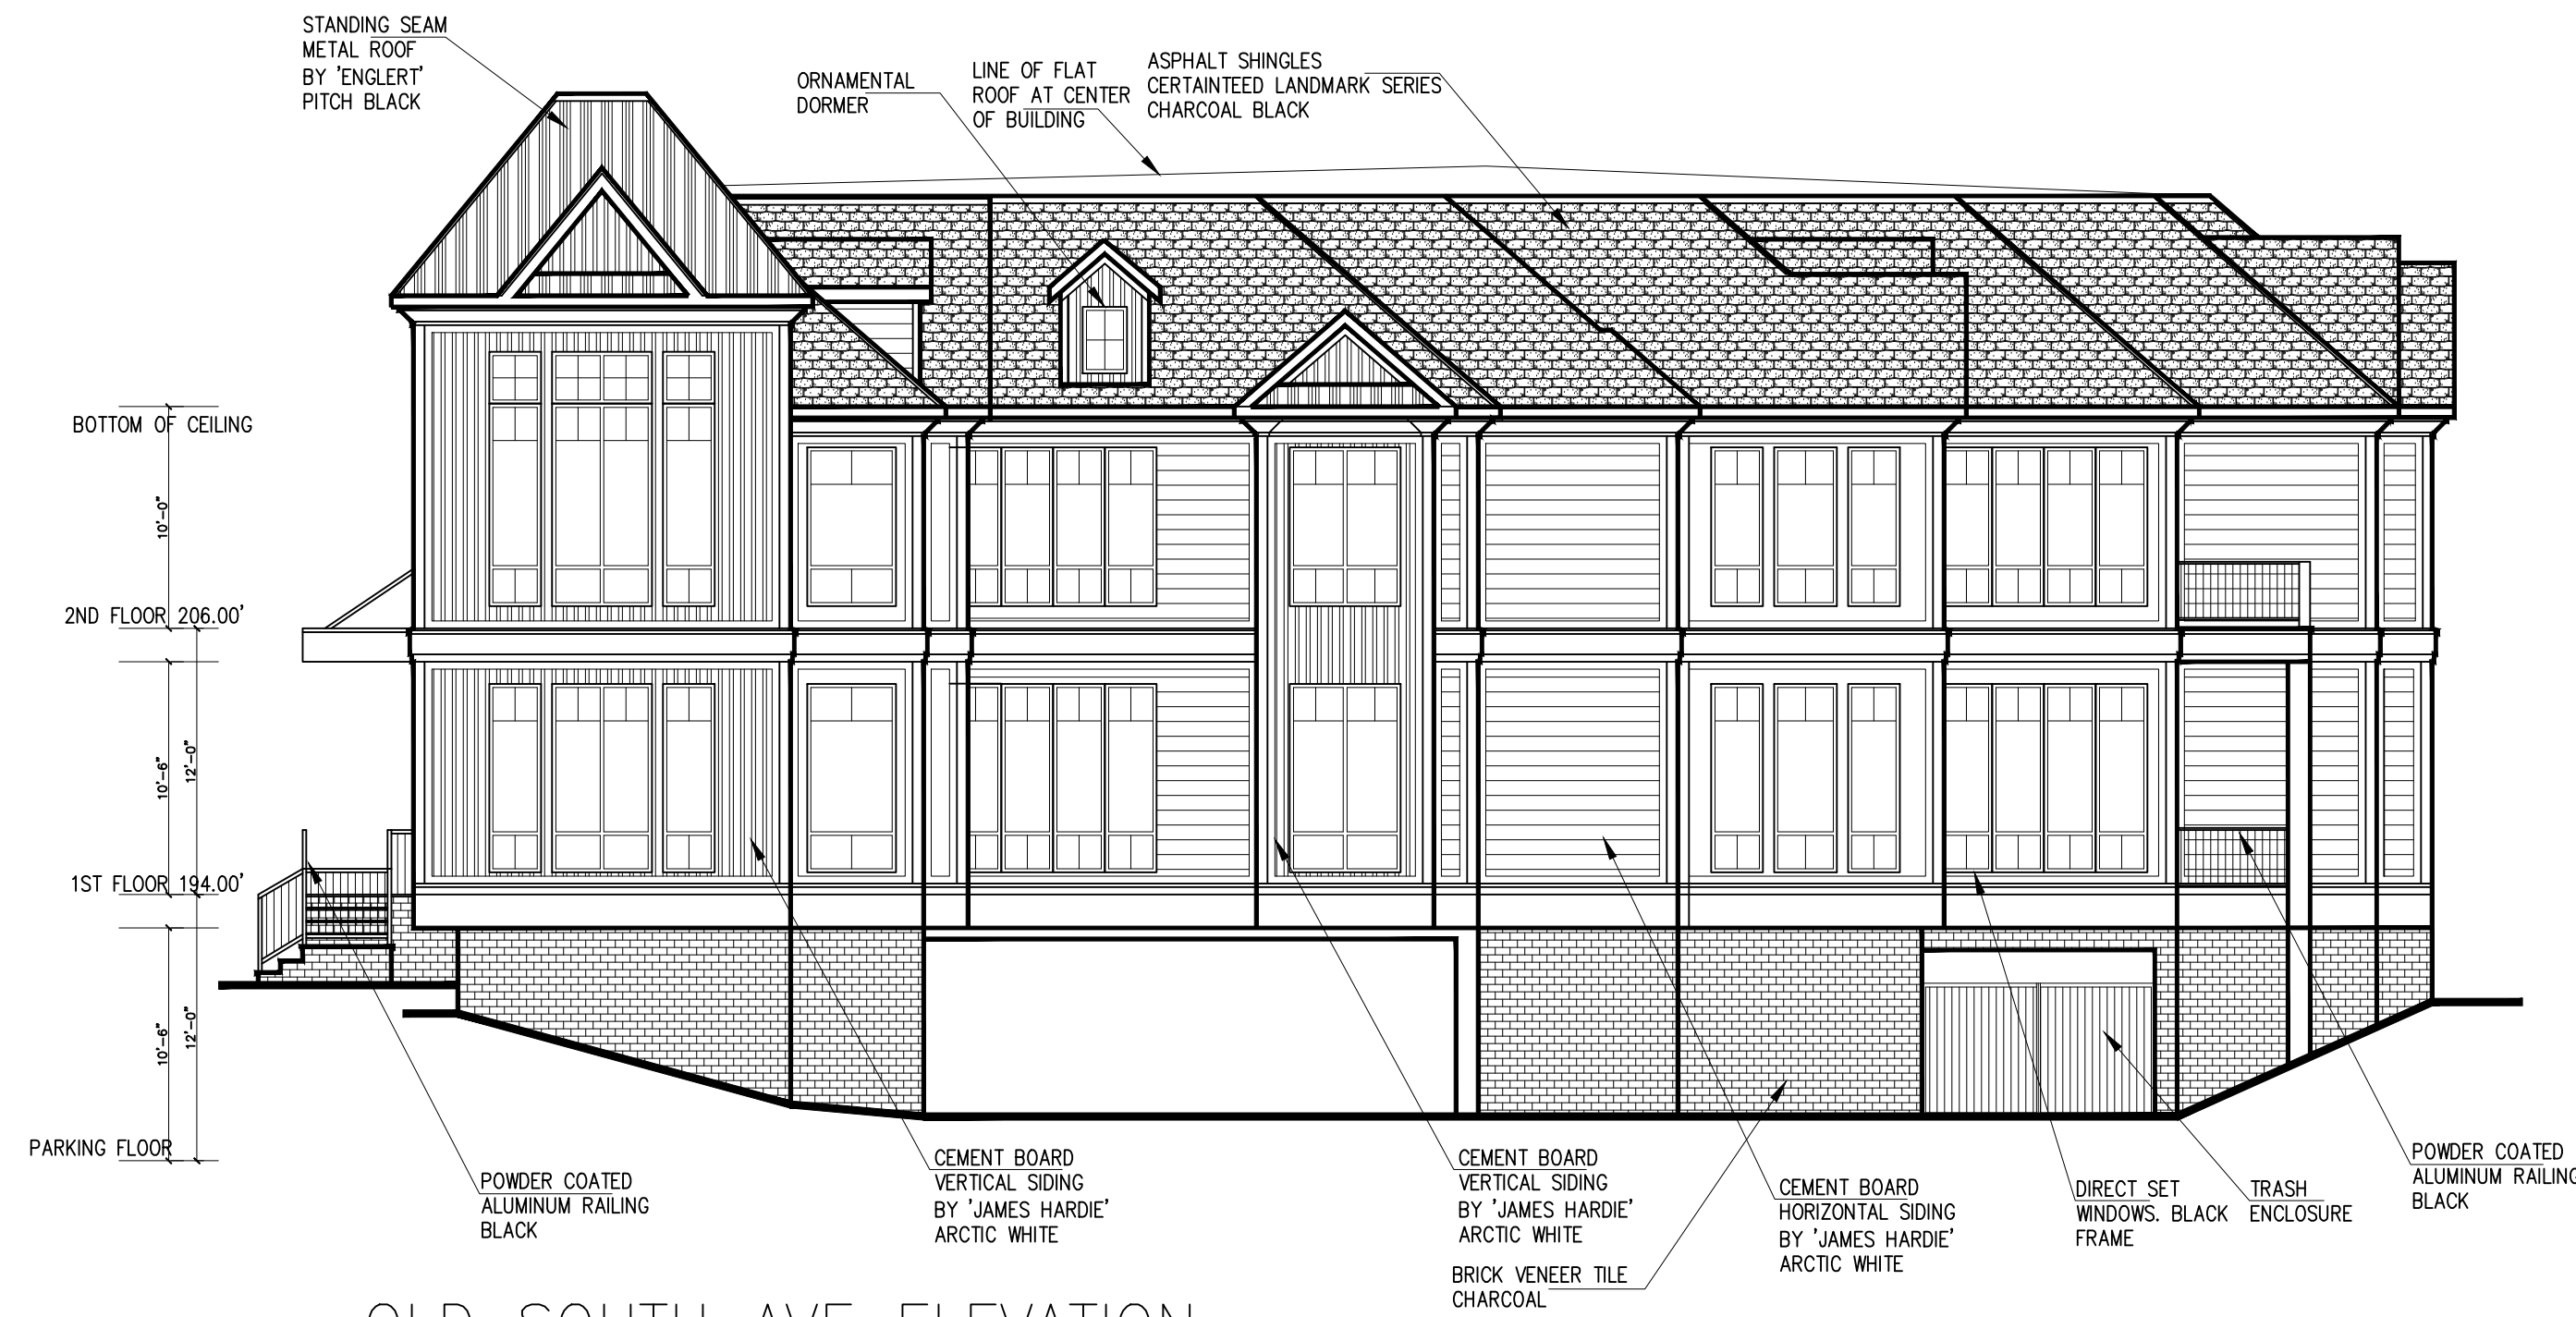

OLD SOUTH AVE ELEVATION

SCALE: 1/8" = 1'-0"

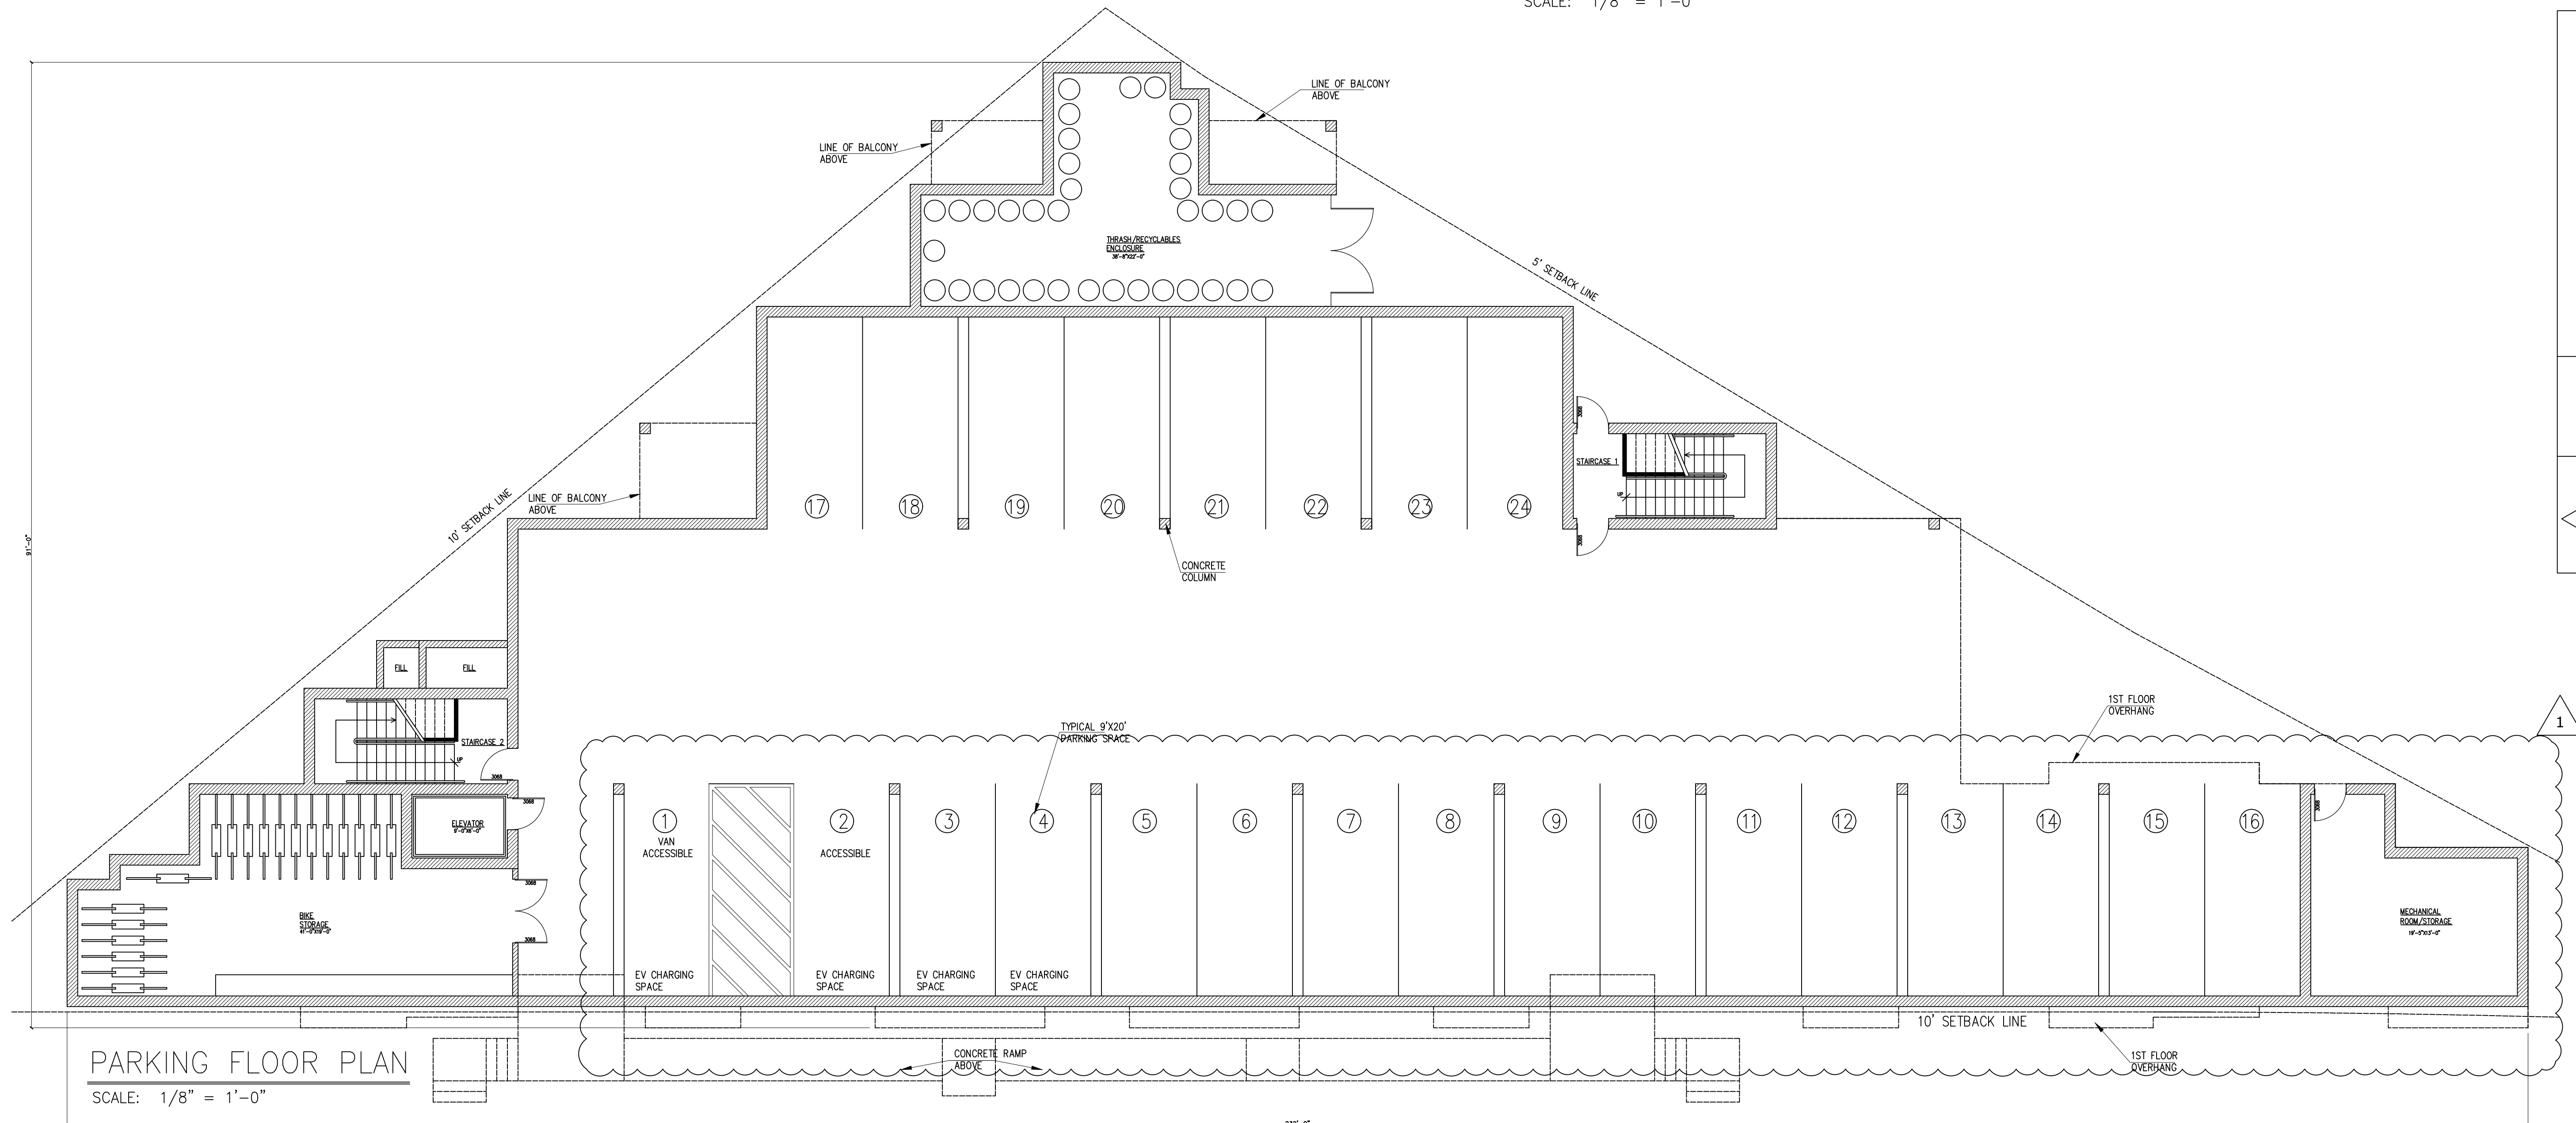

PARKING FLOOR PLAN

SCALE: 1/8" = 1'-0"

1	4.22.25	REVISIONS AS PER BOROUGH'S REVIEW COMMENTS
Date	Project Title	Job #
01.26.25	NEW MULTIFAMILY BUILDING	25-008
Scale	383 SOUTH AVE., FANWOOD, N.J.	Dwg. #
AS NOTES		A - 3
Drawn by	Drawing Title	OF 3
J.D.	PARKING FLOOR PLAN, WEST ELEVATION, OLD SOUTH AVE ELEVATION.	
Checked by		
A.P.		

[Signature]

architect
ANDREW PODBIEZNIAK R.A.
11 High Point Drive
Springfield N.J. 07081
Tel: 973-493-9476
Fax: 908-277-6007
N.J. Lic # 12241